


# LEGACY 10 Model

SPECIFICATIONS	
SHELL WEIGHT:	3000 LBS.
WATER WEIGHT:	5737 LBS.
TOTAL SHELL & WATER WEIGHT:	8737.2 LBS.
WATER VOLUME:	115 Cu.Ft.
WATER GALLONS:	860 GAL.
SURFACE AREA:	39 SQ. FT.
ICC ES LISTED #:	PMG-1161
FDA#:	2030305

Autocover color to be selected upon tile arrival.  
**Charcoal**

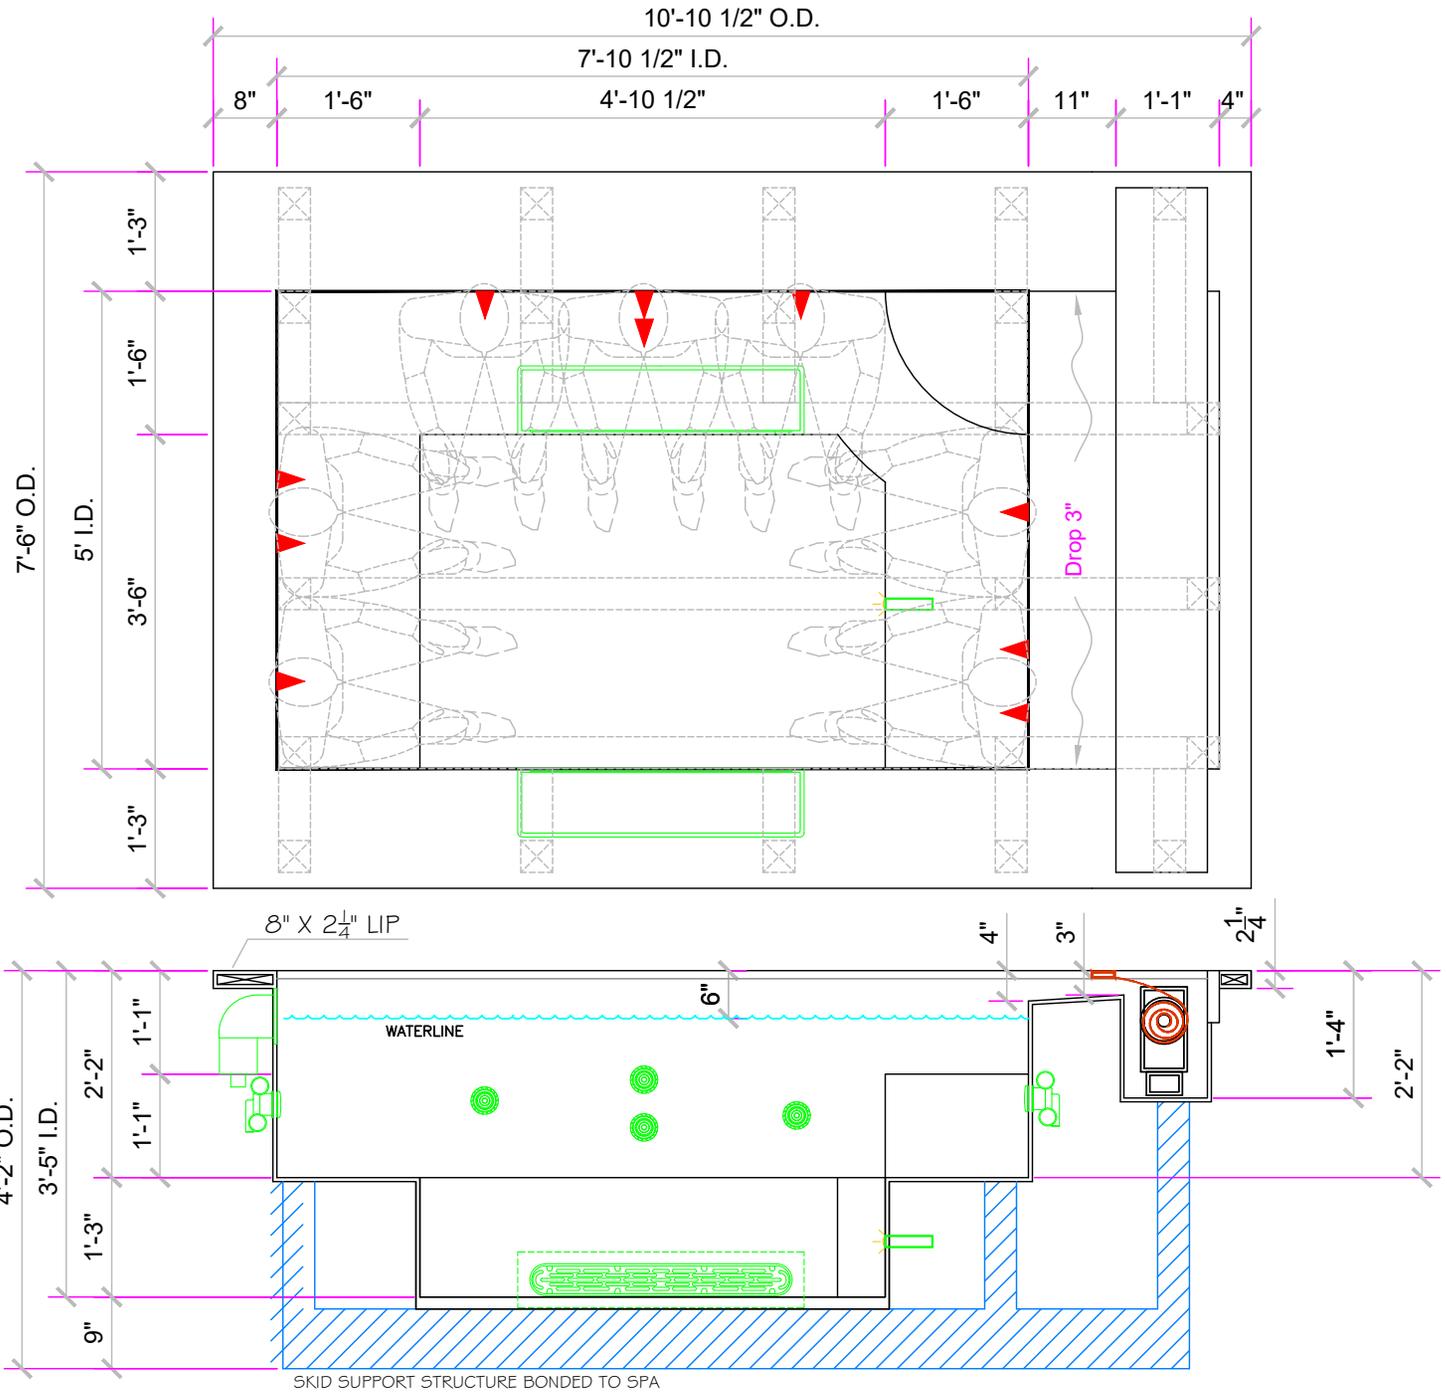

**APPROVED**

ALL DIMENSIONS SUBJECT TO 1/4" TOLERANCES

These drawings, concepts, and details contained herein are the original proprietary designs of **NESPA ENTERPRISES INC.**, developed over many years of experience in the industry and as such are protected by the copyright laws of the United States Government. Reproduction of any of the above without written permission to do so by **NESPA ENTERPRISES INC.**, is illegal.


**NESPA ENTERPRISES INC.**  
 2800 Richter Ave. Ste. C Oroville, CA 95966  
 Office: (530) 534-9910 Fax: (530) 534-9915  
 E-Mail: [jim@tiledspas.com](mailto:jim@tiledspas.com) Web Site: [www.tiledspas.com](http://www.tiledspas.com)



If printing as a PDF:  
 Page Scaling:   
 DWG NAME: HOHMAN

SCALE: 1/2" = 1'  
 DATE: 5/29/2018

DWG TYPE: SD  
 SHEET: PAGE 1 OF 4

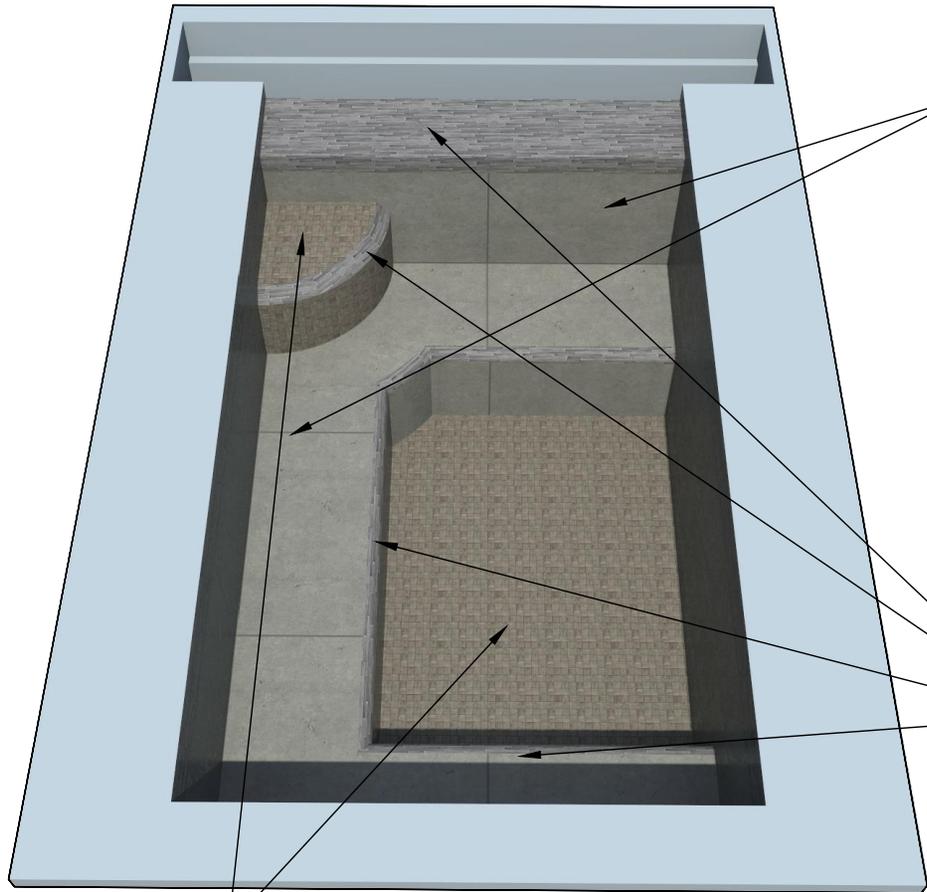

**Cornerstone Slate Black Natural Rett.**  
 E7KY 6984F9R - 89 - 23 5/8" x 47 1/4"



60x120 (23<sup>5/8</sup>"x47<sup>1/4</sup>")  
**E7KY 984F9R SLATE BLACK NAT. RETT.** ● 89

Waterline, weir and step bench edges:  
**Cornerstone Slate Black Natural** -  
 Pencil Cut



Floor and Top Step Tread




**APPROVED**



# Easytouch - 2 PUMP - Heat Exchanger - Low Voltage Light

**NOTE:**  
THIS SCHEMATIC IS FOR CONCEPTUAL PURPOSES ONLY.  
ALL WORK SHALL BE PERFORMED BY A LICENSED  
ELECTRICIAN AND COMPLY WITH THE NATIONAL  
ELECTRICAL CODE.

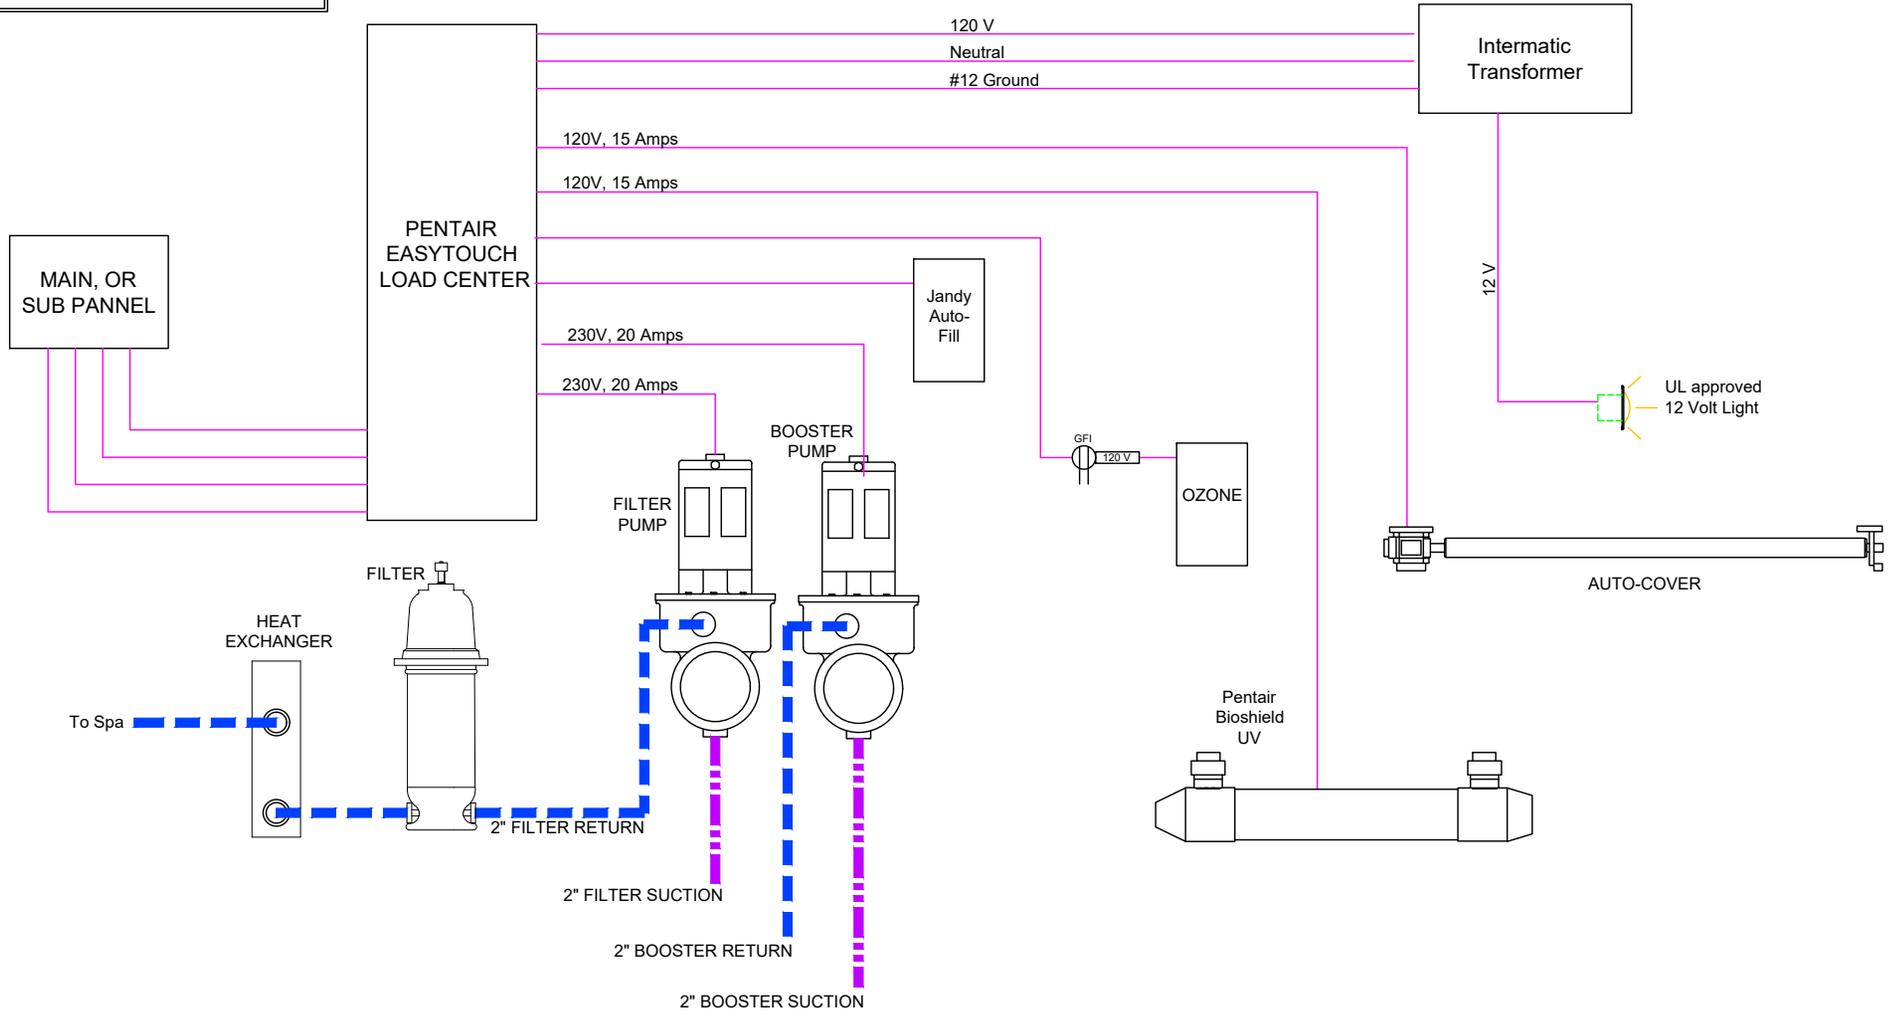

**APPROVED**


These drawings, concepts, and details contained herein are the original proprietary designs of **NESPA ENTERPRISES INC.**, developed over many years of experience in the industry and as such are protected by the copyright laws of the United States Government. Reproduction of any of the above without written permission to do so by **NESPA ENTERPRISES INC.**, is illegal

**NESPA ENTERPRISES INC.**  
2800 Richter Ave. Ste. C Oroville, CA 95966  
Office: (530) 534-9910 Fax: (530) 534-9915  
E-Mail: [jim@tiledspas.com](mailto:jim@tiledspas.com) Web Site: [www.tiledspas.com](http://www.tiledspas.com)




**If printing as a PDF:**  
Page Scaling:   
DWG NAME: **HOHMAN**


SCALE: **N/A**  
DATE: **5/29/2018**

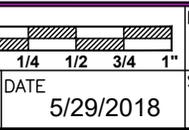

DWG TYPE: **Electrical**  
SHEET: **PAGE 3 OF 4**

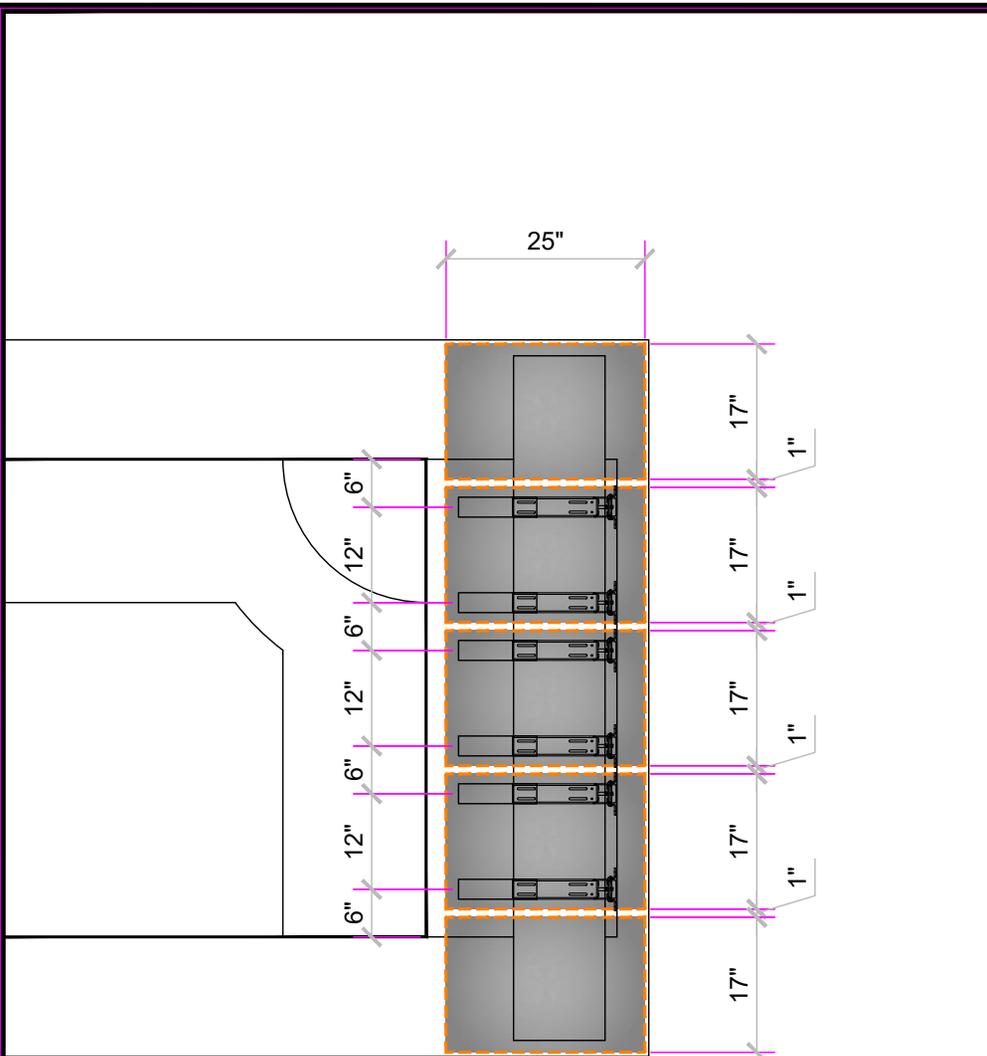

SCALE  
1/2" = 1'

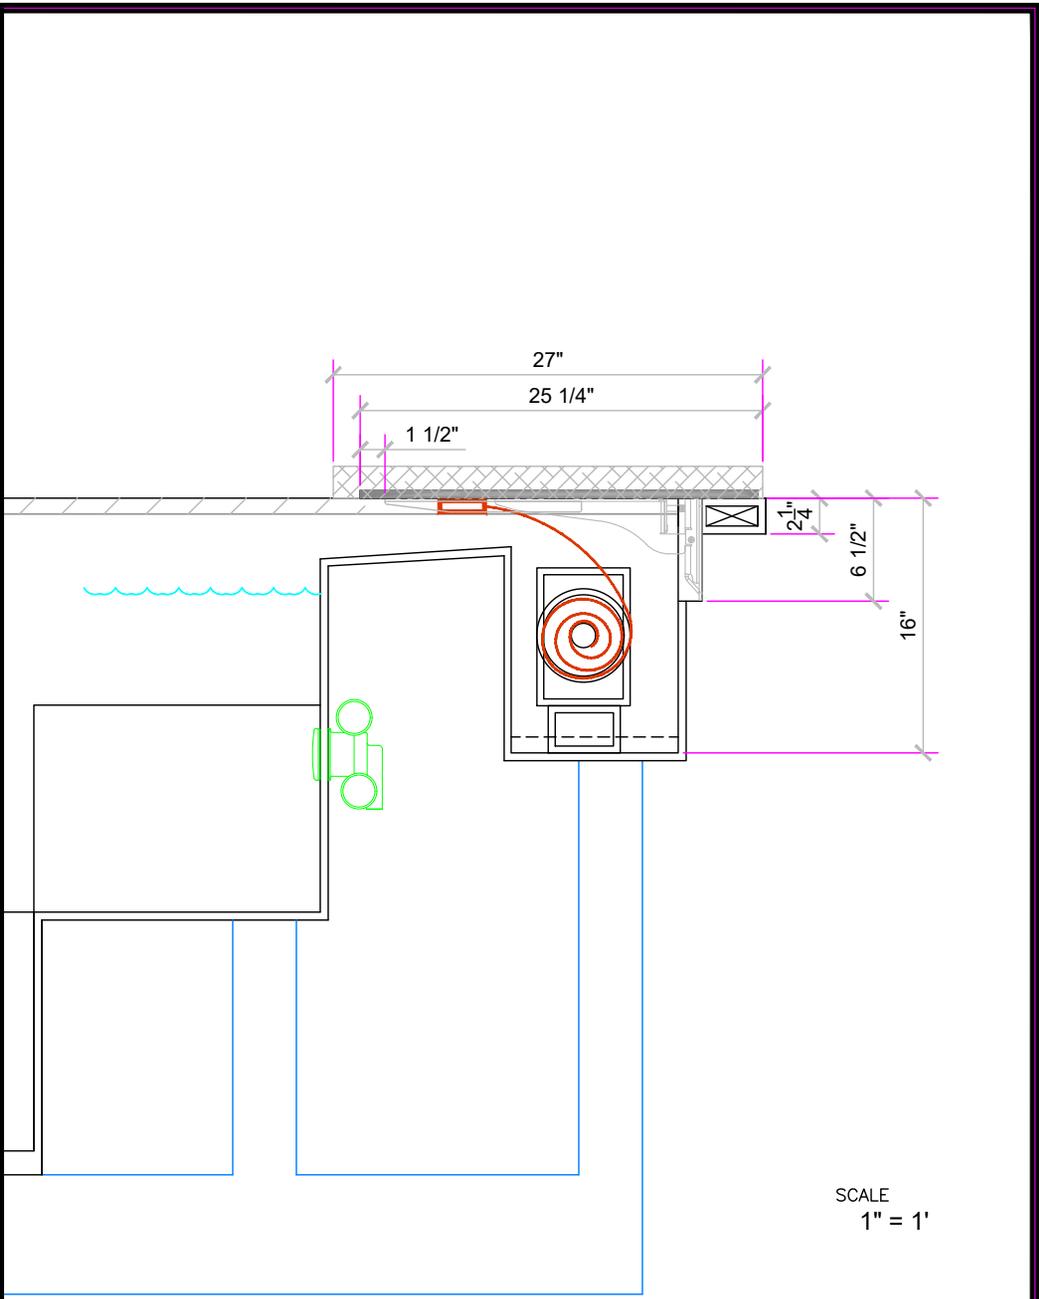

SCALE  
1" = 1'

**APPROVED**


These drawings, concepts, and details contained herein are the original proprietary designs of **NESPA ENTERPRISES INC.**, developed over many years of experience in the industry and as such are protected by the copyright laws of the United States Government. Reproduction of any of the above without written permission to do so by **NESPA ENTERPRISES INC.**, is illegal

**NESPA ENTERPRISES INC.**  
2800 Richter Ave. Ste. C Oroville, CA 95966  
Office: (530) 534-9910 Fax: (530) 534-9915  
E-Mail: [jim@tiledspas.com](mailto:jim@tiledspas.com) Web Site: [www.tiledspas.com](http://www.tiledspas.com)



**If printing as a PDF:**  
Page Scaling:   
DWG NAME: HOHMAN

SCALE: AS NOTED  
DATE: 5/29/2018

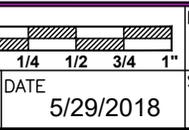

DWG TYPE: Cover Box  
SHEET: PAGE 4 OF 4

Cover Box Drain

2" Filter Return

1-1/2" Skimmer Suction

3" Booster Suction

2" Filter Suction

3" Booster Jet Return



**AS-BUILT**

These drawings, concepts, and details contained herein are the original proprietary designs of [NESPA ENTERPRISES INC.](http://www.nespa.com), developed over many years of experience in the industry and as such are protected by the copyright laws of the United States Government. Reproduction of any of the above without written permission to do so by [NESPA ENTERPRISES INC.](http://www.nespa.com), is illegal.

**NESPA ENTERPRISES INC.**

2800 Richter Ave. Ste. C Oroville, CA 95966

Office: (530) 534-9910

Fax: (530) 534-9915

E-Mail: [jim@tiledspas.com](mailto:jim@tiledspas.com) Web Site: [www.tiledspas.com](http://www.tiledspas.com)




**If printing as a PDF:**

Page Scaling:

DWG NAME **HOHMAN**

SCALE  
N/A

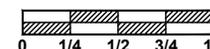

DATE  
8/14/2018

DWG TYPE  
Plumbing ID

SHEET  
PAGE 1 OF 1



Most Widely Accepted and Trusted

# ICC-ES Report

## PMG-1161

ICC-ES | (800) 423-6587 | (562) 699-0543 | www.icc-es.org

Reissued 01/30/2018  
This report is subject to renewal 09/2018

EVALUATION SUBJECT:

## SPA SHELL (TILE LINED FRP)

**DIVISION:**  
13 00 00—SPECIAL CONSTRUCTION  
**SECTION:**  
13 17 00—TUB AND POOLS

Report Holder:

**NESPA ENTERPRISES, INC.**

2800 RICHTER AVENUE, SUITE C  
OROVILLE, CA 95966



Look for the ICC-ES marks of Conformity!



ICC-ES Evaluation Reports are not to be construed as representing aesthetics or any other attributes not specifically addressed, nor are they to be construed as an endorsement of the subject of the report or a recommendation for its use. There is no warranty by ICC Evaluation Service, LLC, express or implied, as to any finding or other matter in this report, or as to any product covered by the report. Copyright © 2017 ICC Evaluation Service, LLC. All rights reserved.



### NESPA ENTERPRISES INC.

2800 Richter Ave. Suite C Oroville, CA 95966

Office: (530) 534-9910 Fax: (530) 534-9915

E-Mail: [jim@tiledspas.com](mailto:jim@tiledspas.com) Web Site: [www.tiledspas.com](http://www.tiledspas.com)



If printing as a PDF:

Page Scaling:

DWG NAME HOHMAN

SCALE

N/A

0 1/4 1/2 3/4 1"

DATE 4/18/2018

DWG TYPE

ICC

SHEET

PAGE 1 OF 3

These drawings, concepts, and details contained herein are the original proprietary designs of NESPA ENTERPRISES INC., developed over many years of experience in the industry and as such are protected by the copyright laws of the United States Government. Reproduction of any of the above without written permission to do so by NESPA ENTERPRISES INC., is illegal.

**ICC-ES PMG Product Certificate**

**PMG-1161**



Effective Date: September 2017

Revision Date: January 30, 2018

This listing is subject to re-examination in one year.

[www.icc-es-pmg.org](http://www.icc-es-pmg.org) | (800) 423-6587 | (562) 699-0543 A Subsidiary of the International Code Council®

CSI: DIVISION: 13 00 00 – SPECIAL CONSTRUCTION  
Section: 13 17 00 – Tub and Pools

Product certification system:

The ICC-ES product certification system includes testing samples taken from the market or supplier's stock, or a combination of both, to verify compliance with applicable codes and standards. The system also involves factory inspections, and assessment and surveillance of the supplier's quality system.

Product: Spa Shell (Tile Lined FRP)

Listee: Nespa Enterprises, Inc.  
2800 Richter Avenue, Suite C  
Oroville, CA 95966  
[www.tiledspas.com](http://www.tiledspas.com)

Compliance with the following codes:

2018, 2015, 2012 and 2009 *International Swimming Pool and Spa Code*™ (ISPSC)  
2015, 2012 and 2009 *Uniform Swimming Pool, Spa and Hot Tub Code*® (USPSHTC)\*

\*Uniform Swimming Pool, Spa and Hot Tub Code is a copyrighted publication of the International Association of Plumbing and Mechanical Officials

Compliance with the following standards:

IAPMO/ANSI Z124.7-2013, Prefabricated Plastic Spa Shells  
ANSI/APSP/ICC-3 2014, Permanently Installed Residential Spas and Swim Spas (formally ANSI/NSPI-3 2014)

Identification:

Each unit of Spa Shell shall be marked with manufacturer's name or trademark and ICC-ES PMG mark of conformity. Marking shall be permanent and legible so as to be visible after installation. A label shall be permanently affixed to each unit in a visible location and shall include the manufacturer's name and/or trademark, and model designation. Units manufactured as "Shell Only" shall be so identified and labeled. Unit shall be permitted to be marked "IAPMO/ANSI Z124.7" signifying compliance with the standard.

Installation:

Each unit of Spa shell shall be installed in accordance with manufacturer's published installation instructions and applicable codes.

*Listings are not to be construed as representing aesthetics or any other attributes not specifically addressed, nor are they to be construed as an endorsement of the subject of the listing or a recommendation for its use. There is no warranty by ICC Evaluation Service, LLC, express or implied, as to any finding or other matter in this listing, or as to any product covered by the listing.*



Copyright © 2018 ICC Evaluation Service, LLC. All rights reserved.

Page 1 of 2

**NESPA ENTERPRISES INC.**

2800 Richter Ave. Suite C Oroville, CA 95966

Office: (530) 534-9910 Fax: (530) 534-9915

E-Mail: [jim@tiledspas.com](mailto:jim@tiledspas.com) Web Site: [www.tiledspas.com](http://www.tiledspas.com)




If printing as a PDF:

Page Scaling:

DWG NAME HOHMAN

SCALE N/A

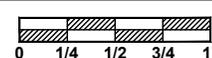

DATE 4/18/2018

DWG TYPE ICC (2)

SHEET PAGE 1 OF 3

Models:

Acapulco	Legacy 14'	Mirage 17'
Acapulco II	Legacy 16'	Modera Pool 1327
Acapulco III	Legacy 18'	Monaco
Acapulco IV	Legacy 20'	Nespa Pool Infinity 825
6.5' Acapulco	Legacy 6' x 9' CS	Nespa Pool Infinity 1035
7.5' Acapulco	Legacy 6.3' x 10.3' CS	Nespa Pool 1020 GTR
9' Acapulco	Legacy 7.5' x 16' CS	Nespa Pool 1020 SKM
10' Acapulco	Legacy 7'4" x 18' CS	Therapy Pool 1020-2W-CS
BERKELEY M	Legacy 8' x 8' CS	Therapy Pool 1020-2W-Center
BERKELEY W	Legacy 8' x 10' CS	Therapy Pool 1020-2W-ES-2RF
Blackthome	Legacy 8' x 10' CS 46	Nespa Swim Spa 12'
Capri	Legacy 8' x 12' CS	Nespa Swim Spa 16'
Caribbean	Legacy 8' x 14' CS	Nespa Swim Spa 18'
Collective 4 <sup>th</sup>	Legacy 8' x 15' CS	Nespa Swim Spa 20'
Collective 15 <sup>th</sup>	Legacy 8' x 16' DS	PALISADES
Corsica	Legacy 8' x 18' DS	PISMO POOL
Corsica-Modified	Legacy 8' x 20' DS	Redmond Ridge
6' x 8' Corsica	Legacy 9' x 14' CS	REDWOOD
7' x 9' Corsica	Legacy 9' x 16' CS	Rimini
8' x 10' Corsica	Legacy 9' x 18' CS	Rimini Commercial
Corsica II	Legacy 10' x 10' CS	Rimini II
Corsica III	Legacy 10' x 12' CS	Rimini III
Eight Ft. Round	Legacy 10' x 14' CS	Roman 625
GSW-1	Legacy 10' x 16' CS	Round 7'
GSW-2	Legacy 10' x 18' CS	Round 9'
Imperia	Legacy 10' x 20' CS	Round 11'
Imperia II	Legacy 12' x 18' CS	6.5' Round
Jensen Deluxe	Legacy 40	7.5' Round
Mod. Imperia	Legacy 8420 CS	8.5' Round
Kidney	Legacy P-CS - 9 x 16	9 Round Mod
Legacy Pool Series	Legacy P-CS - 9 x 18	Serenity 12'
Legacy 45	Legacy Serra 40S	Six Ft. Round
Legacy C	Legacy Serra 40G	Tahoe
Legacy DW Series	Maxima	Ten Ft. Round
Legacy Infinity DS	Maxima II	Therapy Pool
Legacy M Series	Mirage 9'	Therapy Pool 1016-15W-CS
Legacy Para	Mirage 11'	Therapy Pool 1018-2W-CS
Legacy 10'	Mirage 13'	Vallarta
Legacy 12'	Mirage 15'	WALDORF

Tile lined, polyester resin reinforced fiberglass spa shells in various colors, sizes, and configurations. May or may not be provided with insulation. All units, whether factory or field assembled, are required to have suction fittings installed which are certified to ASME A112.19.8 or ANSI/APSP-16 for anti-hair and body entrapment. All units are listed for above or below ground installation and may be portable or permanent.

Conditions of listing:

1. NESPA's Spa Shell shall be installed in accordance with manufacturer's published installation instruction and applicable codes.
2. NESPA Spa Shell is manufactured in Oroville, California under a quality control program with annual inspection by ICC-ES.

**NESPA ENTERPRISES INC.**

2800 Richter Ave. Suite C Oroville, CA 95966

Office: (530) 534-9910

Fax: (530) 534-9915

E-Mail: [jim@tiledspas.com](mailto:jim@tiledspas.com) Web Site: [www.tiledspas.com](http://www.tiledspas.com)



If printing as a PDF:

Page Scaling:

DWG NAME: HOHMAN

SCALE

N/A



DWG TYPE

ICC (3)


DATE: 4/18/2018

SHEET: PAGE 1 OF 3

# POOL BONDING REQUIREMENTS:

1. THE FOLLOWING PARTS SHALL BE BONDED TOGETHER AND CONNECTED TO THE COMMON BONDING GRID.
  - A. ALL THE METALLIC PARTS OF THE POOL STRUCTURE INCLUDING COPING STONES, DECK, PERMANENT PLAY STRUCTURES, PERMANENT EXERCISE STRUCTURES.
  - B. ALL METAL FITTINGS WITHIN OR ATTACHED TO THE POOL STRUCTURE
  - C. METAL PARTS ASSOCIATED WITH THE POOL WATER CIRCULATING SYSTEM, INCLUDING PUMPS, FILTERS, AND HEATERS.
  - D. METAL PARTS ASSOCIATED WITH POOL COVERS
  - E. METAL SHEATHED CABLES AND RACEWAYS, METAL PIPING AND ALL FIXED METAL PARTS WITHIN 5 FEET HORIZONTALLY OF INSIDE WALLS OF POOL AND WITHIN 12 FEET ABOVE MAXIMUM WATER LEVEL OF POOL.
  - F. METAL PARTS ASSOCIATED WITH OBSERVATION STANDS, TOWERS, PLATFORMS, AND DIVING STRUCTURES.
2. BONDING CONDUCTORS SHALL BE MINIMUM #8 SOLID COPPER, INSULATED E.C. SHALL COORDINATE APPROVED CONNECTOR TYPE AND METHOD WITH LOCAL ELECTRICAL AND/ OR POOL INSPECTOR.
3. SPECIFIC MANUFACTURER'S INSTRUCTIONS REGARDING BONDING OR GROUNDING OF POOL EQUIPMENT, WHETHER INDICATED HEREIN OR NOT, SHALL BE STRICTLY FOLLOWED.
4. THE COMMON BONDING GRID SHALL NOT BE CONNECTED TO ANY ELECTRICAL DISTRIBUTION EQUIPMENT.
5. ANY PARTS IN ADDITION TO THOSE DESCRIBED HEREIN THAT ARE INDICATED BY POOL CONTRACTOR OR LOCAL INSPECTION AUTHORITY SHALL BE BONDED TO THE COMMON BONDING GRID WITH NO ADDITIONAL COSTS INCURRED BY THE OWNER.
6. THE ELECTRICAL CONTRACTOR SHALL COORDINATE BONDING WITH GENERAL CONTRACTOR.

# LIGHT DETAIL

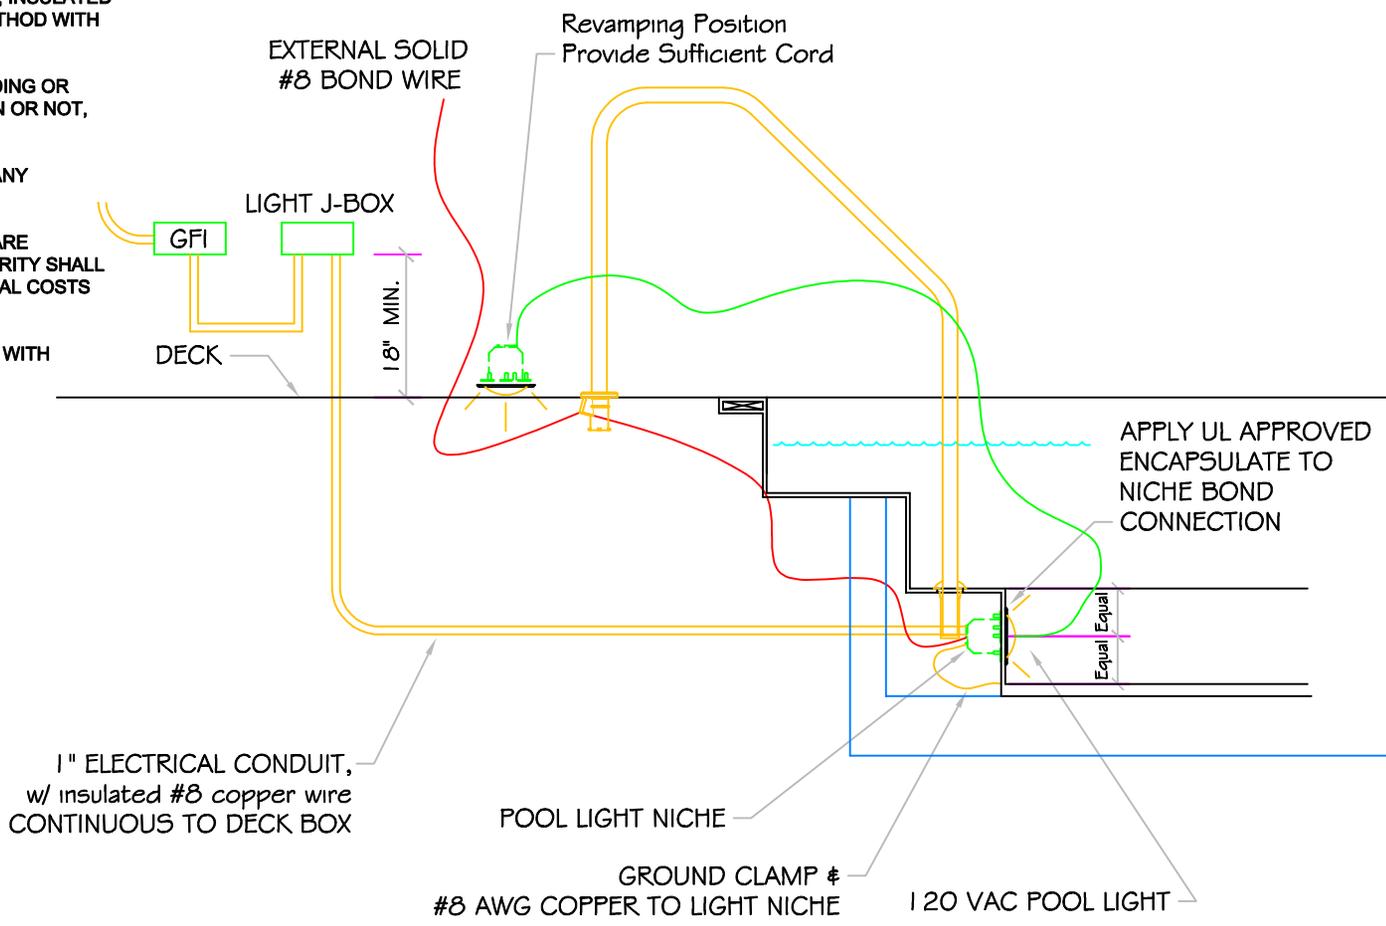

\*ALL DIMENSIONS SUBJECT TO 1/4" TOLERANCES\*

These drawings, concepts, and details contained herein are the original proprietary designs of NESPA ENTERPRISES, developed over many years of experience in the pool and spa industry and as such are protected by the copyright laws of the United States Government. Reproduction of any of the above without written permission to do so by NESPA ENTERPRISES, is illegal.

**NESPA ENTERPRISES INC.**  
 2800 Richter Ave. Ste. C Oroville, CA 95966  
 Office: (530) 534-9910 Fax: (530) 534-9915  
 E-Mail: [sales@tiledspas.com](mailto:sales@tiledspas.com) Web Site: [www.tiledspas.com](http://www.tiledspas.com)



SIZE A	DWG NAME DETAILS	DWG TYPE Detail
SCALE 1/2" = 1'	DATE 7/24/2008	SHEET PAGE 1 OF 1